

MAP 210 LOT 57
N/F RONALD R. HORTON
PO BOX 6377
KATULU, HI 96732
BOOK 1190 PAGE 60

MAP 210 LOT 182
N/F ROSALEE MARY CICCOTELLI
4501 PICOT ROAD
ALEXANDRIA, VA 22310

MAP 210 LOT 54
N/F ALAN D. &
JUDY L. WATFIELD
81 MILTON ROAD
ROCHESTER, NH 03668
BOOK 1157 PAGE 327

MAP 210 LOT 55
55,324.5 S.F.
1.270 AC ±

MILTON ROAD (NH ROUTE 125)

MAP 210 LOT 6
N/F OKEEFE MARTIN JACKSON'S PARTNERSHIP
85 MILTON ROAD
ROCHESTER, NH 03667

MAP 210 LOT 5
N/F MARCIA L. NESBITT
10 CASSIDY LANE
DOVER, NH 03820


LEGEND

- BCC BRICKWORK CONCRETE CURB
VCC VERTICAL GRANITE CURB
SVC SLOPED GRANITE CURB
MCC MONOLITHIC CONCRETE CURB
OSM OVERHEAD SERVICE WIRE
SSW SINGLE SOLID WHITE LINE
DSL DOUBLE SOLID YELLOW LINE
ROF ROOF DRAIN LINE
W- WATER LINE
G- GAS LINE
S- SEWER LINE
D- DRAINAGE LINE
U/EAT UNDERGROUND ELEC. & TEL. LINE
-20- CHAIN LINK FENCE
-I- SIGNS
- UTILITY POLE
DRAIN MANHOLE
SEWER MANHOLE
GAS METER
ELECTRIC METER
ELECTRIC PANEL
SPOT ELEVATION
ENTRY
PARKING COUNT
BOLLARD
FLAGGED END SECTION
LANDSCAPED AREA
EDGE OF PAVEMENT
SPRINKLER CONNECTION
TREE
OBSERVATION WELL

GRAPHIC SCALE




LOCATION MAP

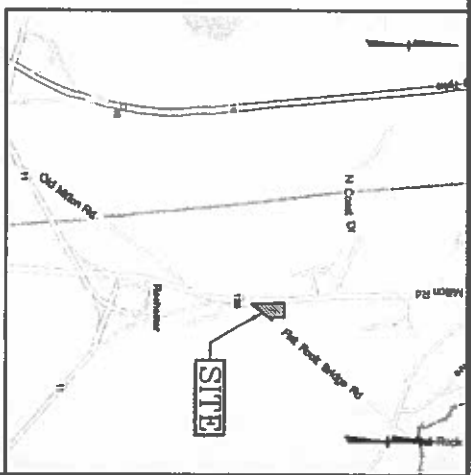

- NOTES:
- 1) LOCATION OF UNDERGROUND UTILITIES IS APPROXIMATE ONLY. ADDITIONAL UNDERGROUND UTILITIES OTHER THAN THOSE SHOWN MAY BE ENCOUNTERED.
 - 2) ELEVATIONS SHOWN HEREON ARE ON NAD 1986 CURB ELEVATIONS SHOWN ARE AT THE "TOE" OF CURB. CURBS ARE 0.50' ± HIGH.
 - 3) THE SURVEY TRACTS ARE LOCATED WITHIN FLOOD ZONE "X" AS TAKEN FROM THE FLOOD INSURANCE RATE MAP FOR STRAFFORD COUNTY, NEW HAMPSHIRE (ALL JURISDICTIONS) PANEL 203 OF 405, MAP NUMBER 33017002030; EFFECTIVE DATE: MAY 17, 2005.
 - 4) THIS PLAN IS THE RESULT OF AN AS-BUILT SURVEY BUT THIS OFFICE DATED NOVEMBER 2, 2015.

NOV 06 2015

Planning Dept.

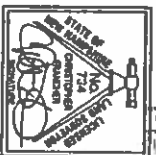

11/4/15

AS-BUILT PLAN

ASSESSORS MAP 210 LOTS 55 & 56
79 MILTON ROAD & 2 FLAT ROCK BRIDGE ROAD
ROCHESTER, NEW HAMPSHIRE
CUMBERLAND FARMS GROUP
100 CROSSING BOULEVARD
FRAMINGHAM, MASSACHUSETTS 01702

DATE: NOVEMBER 4, 2015	CHECKED BY: CWF	PROJECT NO: 344313	SHEET NO: 070220
DATE: NOVEMBER 4, 2015	CHECKED BY: CWF	PROJECT NO: 344313	SHEET NO: 070220