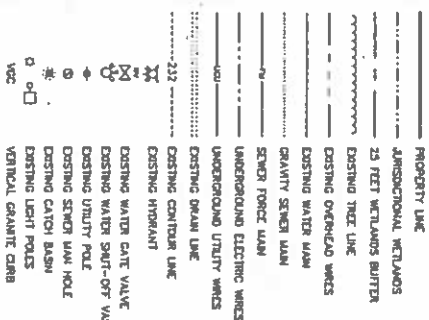


[illegible]

1. THE PURPOSE OF THIS PLAN IS TO SHOW THE AS-BUILT SITE FEATURES THAT WERE DETECTED ON THE REFINISHED PLAN.
2. ALL UNDERGROUND UTILITY LOCATIONS ARE APPROXIMATE AND WERE NOT FIELD LOCATED BY (MHA). SHERMAN PLANS ASSOCIATES, INC. AS-BUILT DRAWINGS WERE SUPPLIED TO MHA BY THE CONSTRUCTION SUPERINTENDENT, MCA. MCA DOES NOT HAVE ANY RESPONSIBILITY FOR THEM ACCURACY AND/OR LOCATION.
3. WORKMAN PLANS CONFIRMS ACCURACY OF ONLY THOSE FEATURES THAT WERE VISUALLY APPARENT ON THE REFINISHED PLAN. THE REFINISHED PLAN DOES NOT SHOW ANY CONSTRUCTION FEATURES OR UTILITIES, ETC. FROM THESE PLANS, BUT IN CONFORMANCE IS NOT INTENDED OR IMPLIED.
4. ORIENTATION: HORIZONTAL AND VERTICAL DATUMS - PER ROCKETSTER DCE.
5. THIS AS-BUILT DRAWING SUBSTANTIALLY CONFORMS WITH THE FINAL PLANS APPROVED BY THE CITY OF ROCKETSTER PLANNING BOARD AND CONTROLLED BY THE PLANNING AND DEVELOPMENT DEPARTMENT. EXCEPT FOR THE FOLLOWING MODIFICATIONS:  
NONE.
6. SEE REFERENCE PLAN 1 (SHEET E-1) FOR WELAND DEDICATION INFORMATION.
7. FOR MORE INFORMATION ABOUT THE SITE PLAN, CONTACT THE CITY OF ROCKETSTER PLANNING DEPARTMENT, 21 WAREHOUS STREET, ROCKETSTER, NH 03067 (603) 235-1236.

1. "IMPOSED SWATH SURGERY COULD BE DOV PRIS INC., LLC," 13 HEALTHCARE DIVE, ROCHESTER, NEW HAMPSHIRE DATED JUNE 13, 2011 BY NORWAY PLAINS ASSOCIATES, INC.
2. "SUBSIDIZED PLAN, ROCHESTER HILL ROAD - IN ROUTE 106, 7A, MAP 242, LOT 38, ROCHESTER, NH," STRANGLING COUNTY PROVIDED FOR HOMEOWNERS' HEALTH SERVICES? DATED APRIL 2011 BY NORWAY PLAINS ASSOCIATES, INC. SCRD PLAN NO.103-17

RECEIVED  
NOV 20 2015  
Planning Dept.

AS-BUILT SITE PLAN  
TAX MAP 243, LOT 39-3  
13 HEALTHCARE DRIVE  
ROCHESTER, NH

**PREPARED FOR:**

DEW FRISBIE ASC, LLC

SCALE: 1" = 40' SEPTEMBER 2016

### GRAPHIC SCALE



(IN FEET)  
1 INCH = 40 FEET

FILE NO. 102  
PLAN NO. C-2695  
DWG. NO. 13124AB/AB-1