



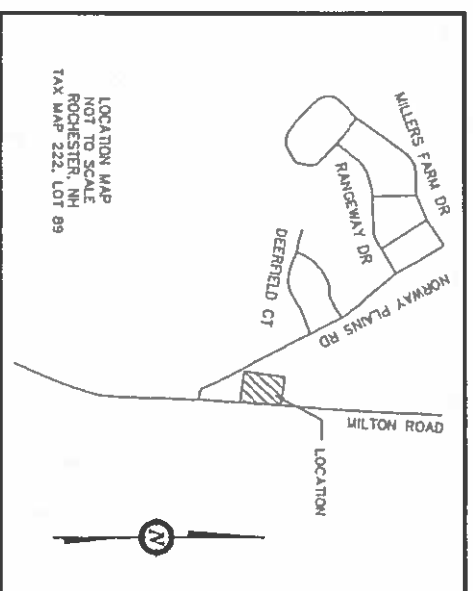

- NOTES:
- 1.) OWNER: TAX MAP 222, LOT B6
ERNA FAZZAS REV. TRUST
140 WESTERLY STREET, EAST ROCHESTER, NH 03607
AND
CHRISTOPHER FAZZAS
17 EASTERN AVENUE, ROCHESTER, NH 03607
- 2.) OWNER: TAX MAP 222, LOT B9
ERNA FAZZAS REV. TRUST & KATHLEEN A
FAZZAS REV. TRUST
141 WADSWELL STREET
EAST ROCHESTER, NH 03607
- 3.) RECORDING: LOT B9 - 5.64 ACRES 4000, PAGE 760
LOT B9 - S.C.D. BOOK 4000, PAGE 757
- 4.) LOT AREA: LOT 60 0.76 ACRES 33,994 SQUARE FEET
LOT 69 1.07 ACRES 46,741 SQUARE FEET
- 5.) THE INTENT OF THIS PLAN IS TO SHOW THE AS-BUILT
CONDITIONS OF AN APPROVED SITE PLAN IN THE CITY OF
ROCHESTER FOR FIRST CITY MOTORS.
- 6.) PORTABLE TOILET PLACED IN MAJOR CIRCULATING DRIVEWAY
CONDITIONS BASED ON MAJOR PER CITY OF ROCHESTER AS
HURTS SURVEY, COOPERATIVE CHAINED USING TYPICAL

RECEIVED
SEP 06 2016
Planning Dept.

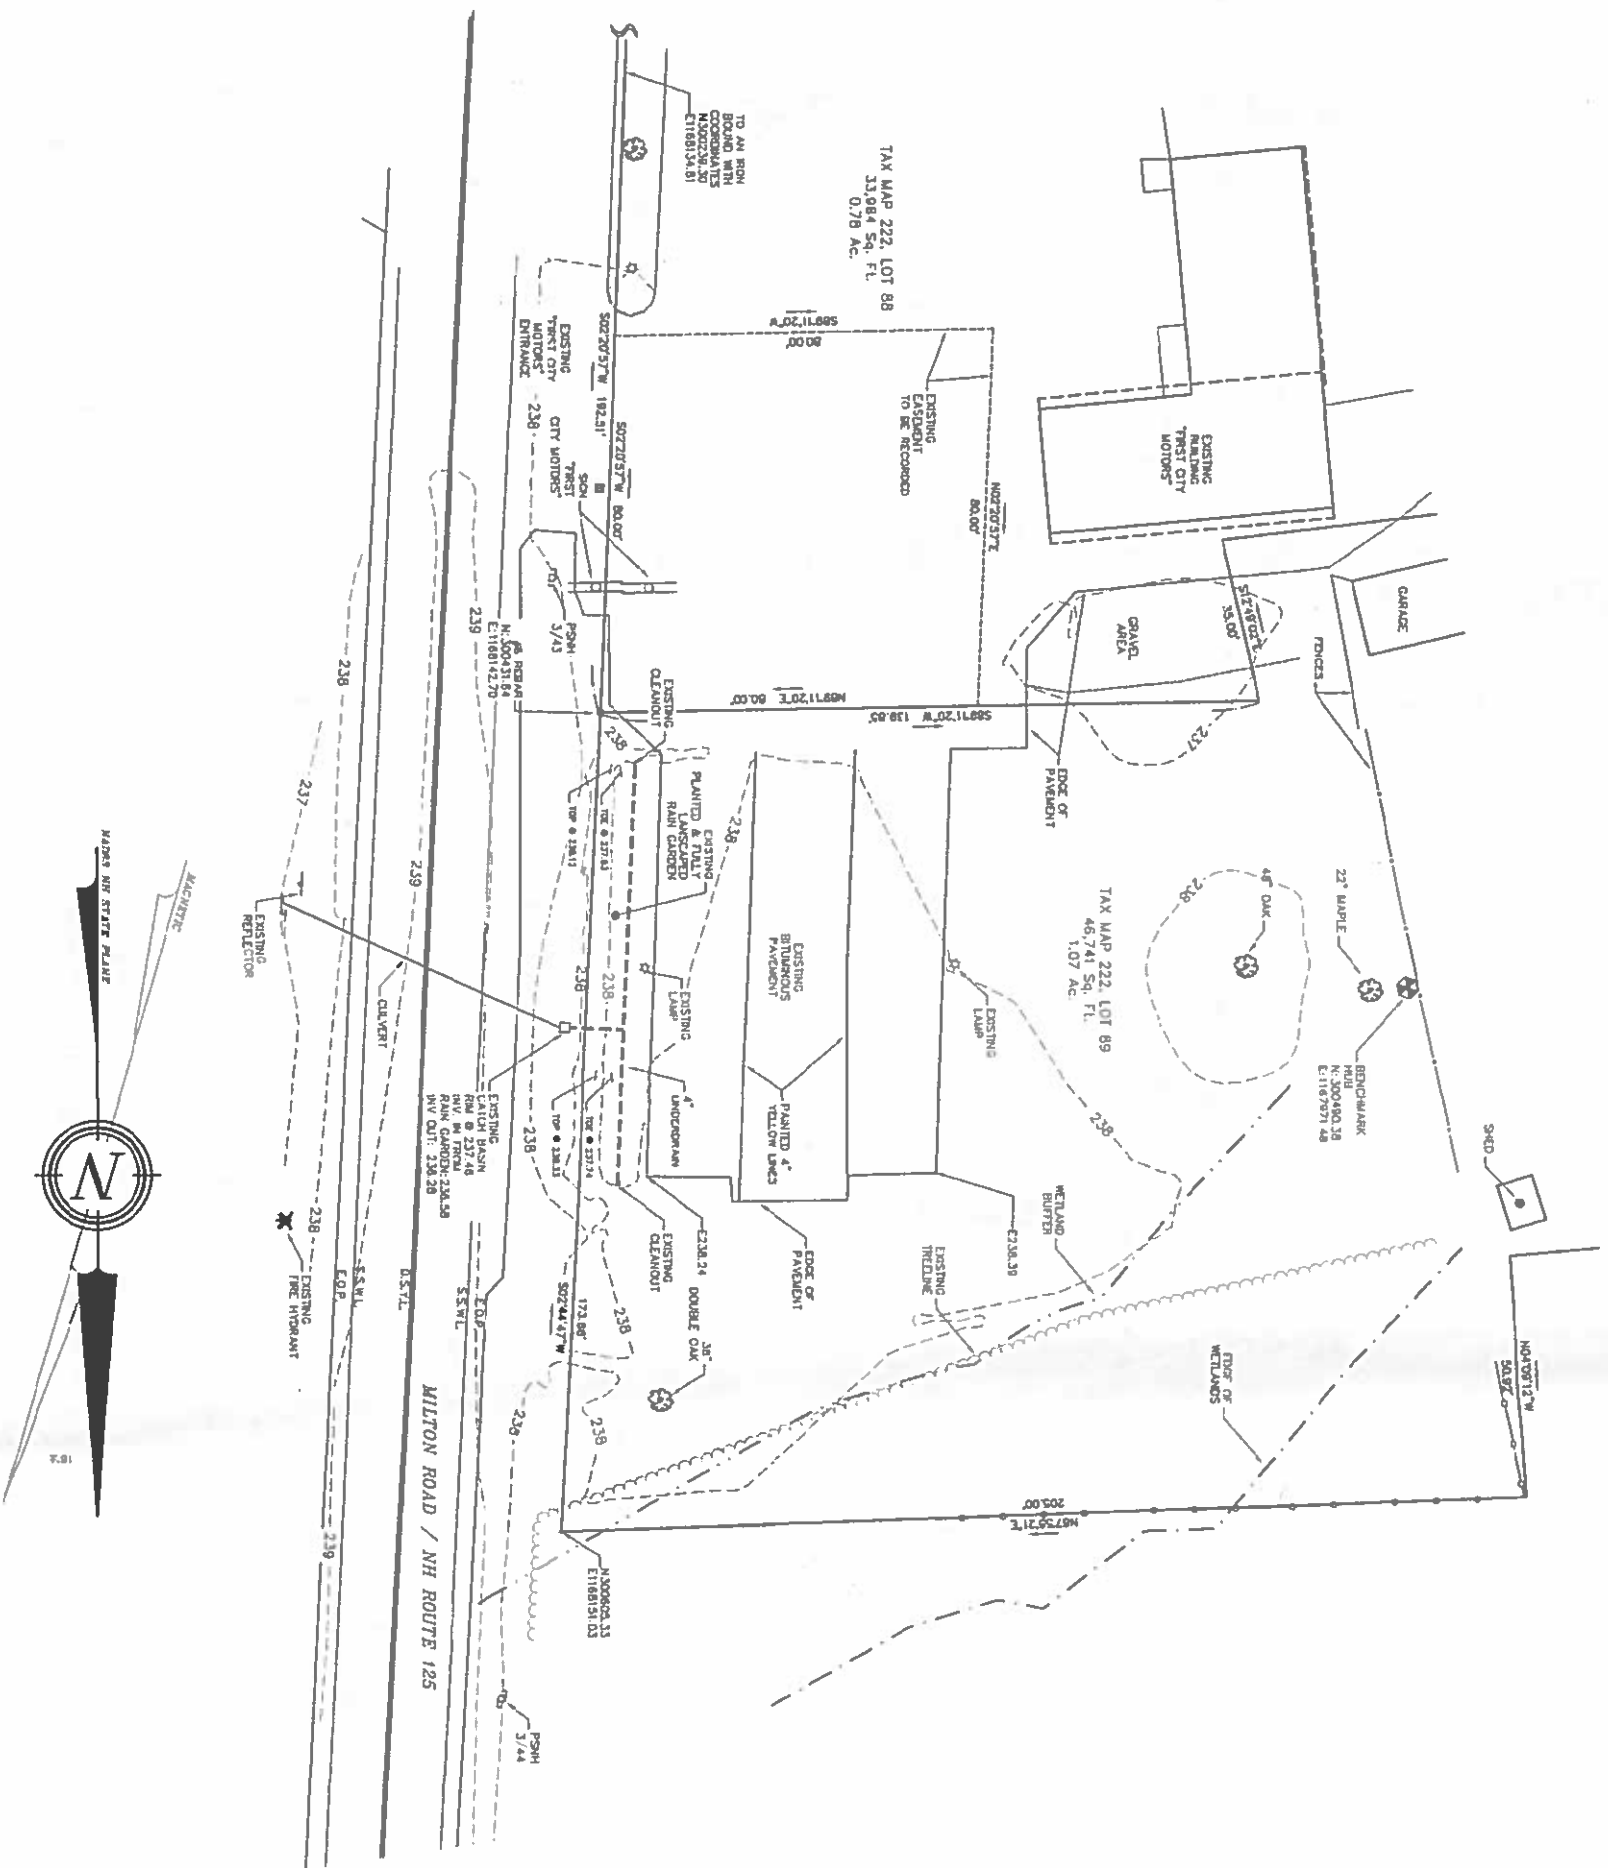

	BERRY SURVEYING & ENGINEERING	
	335 SECOND CROWN POINT ROAD BARRINGTON, NH 03825 (603)332-2863	
	SCALE :	1 IN. EQUALS 20 FT.
	DATE :	SEPTEMBER 5, 2016
FILE NO. :		DB 2016-122

AS-BUILT PLAN
FOR: FIRST CITY MOTORS - LAND OF
ERVIN FAZEKAS REV. TRUST & CHRISTOPHER FAZEKAS
ERVIN FAZEKAS REV. TR. & KATHLEEN A FAZEKAS REV TR.
16 MILTON ROAD, ROCHESTER, NH
TAX MAP 222, LOT 88 & 89

REVISION	DATE	DESCRIPTION