

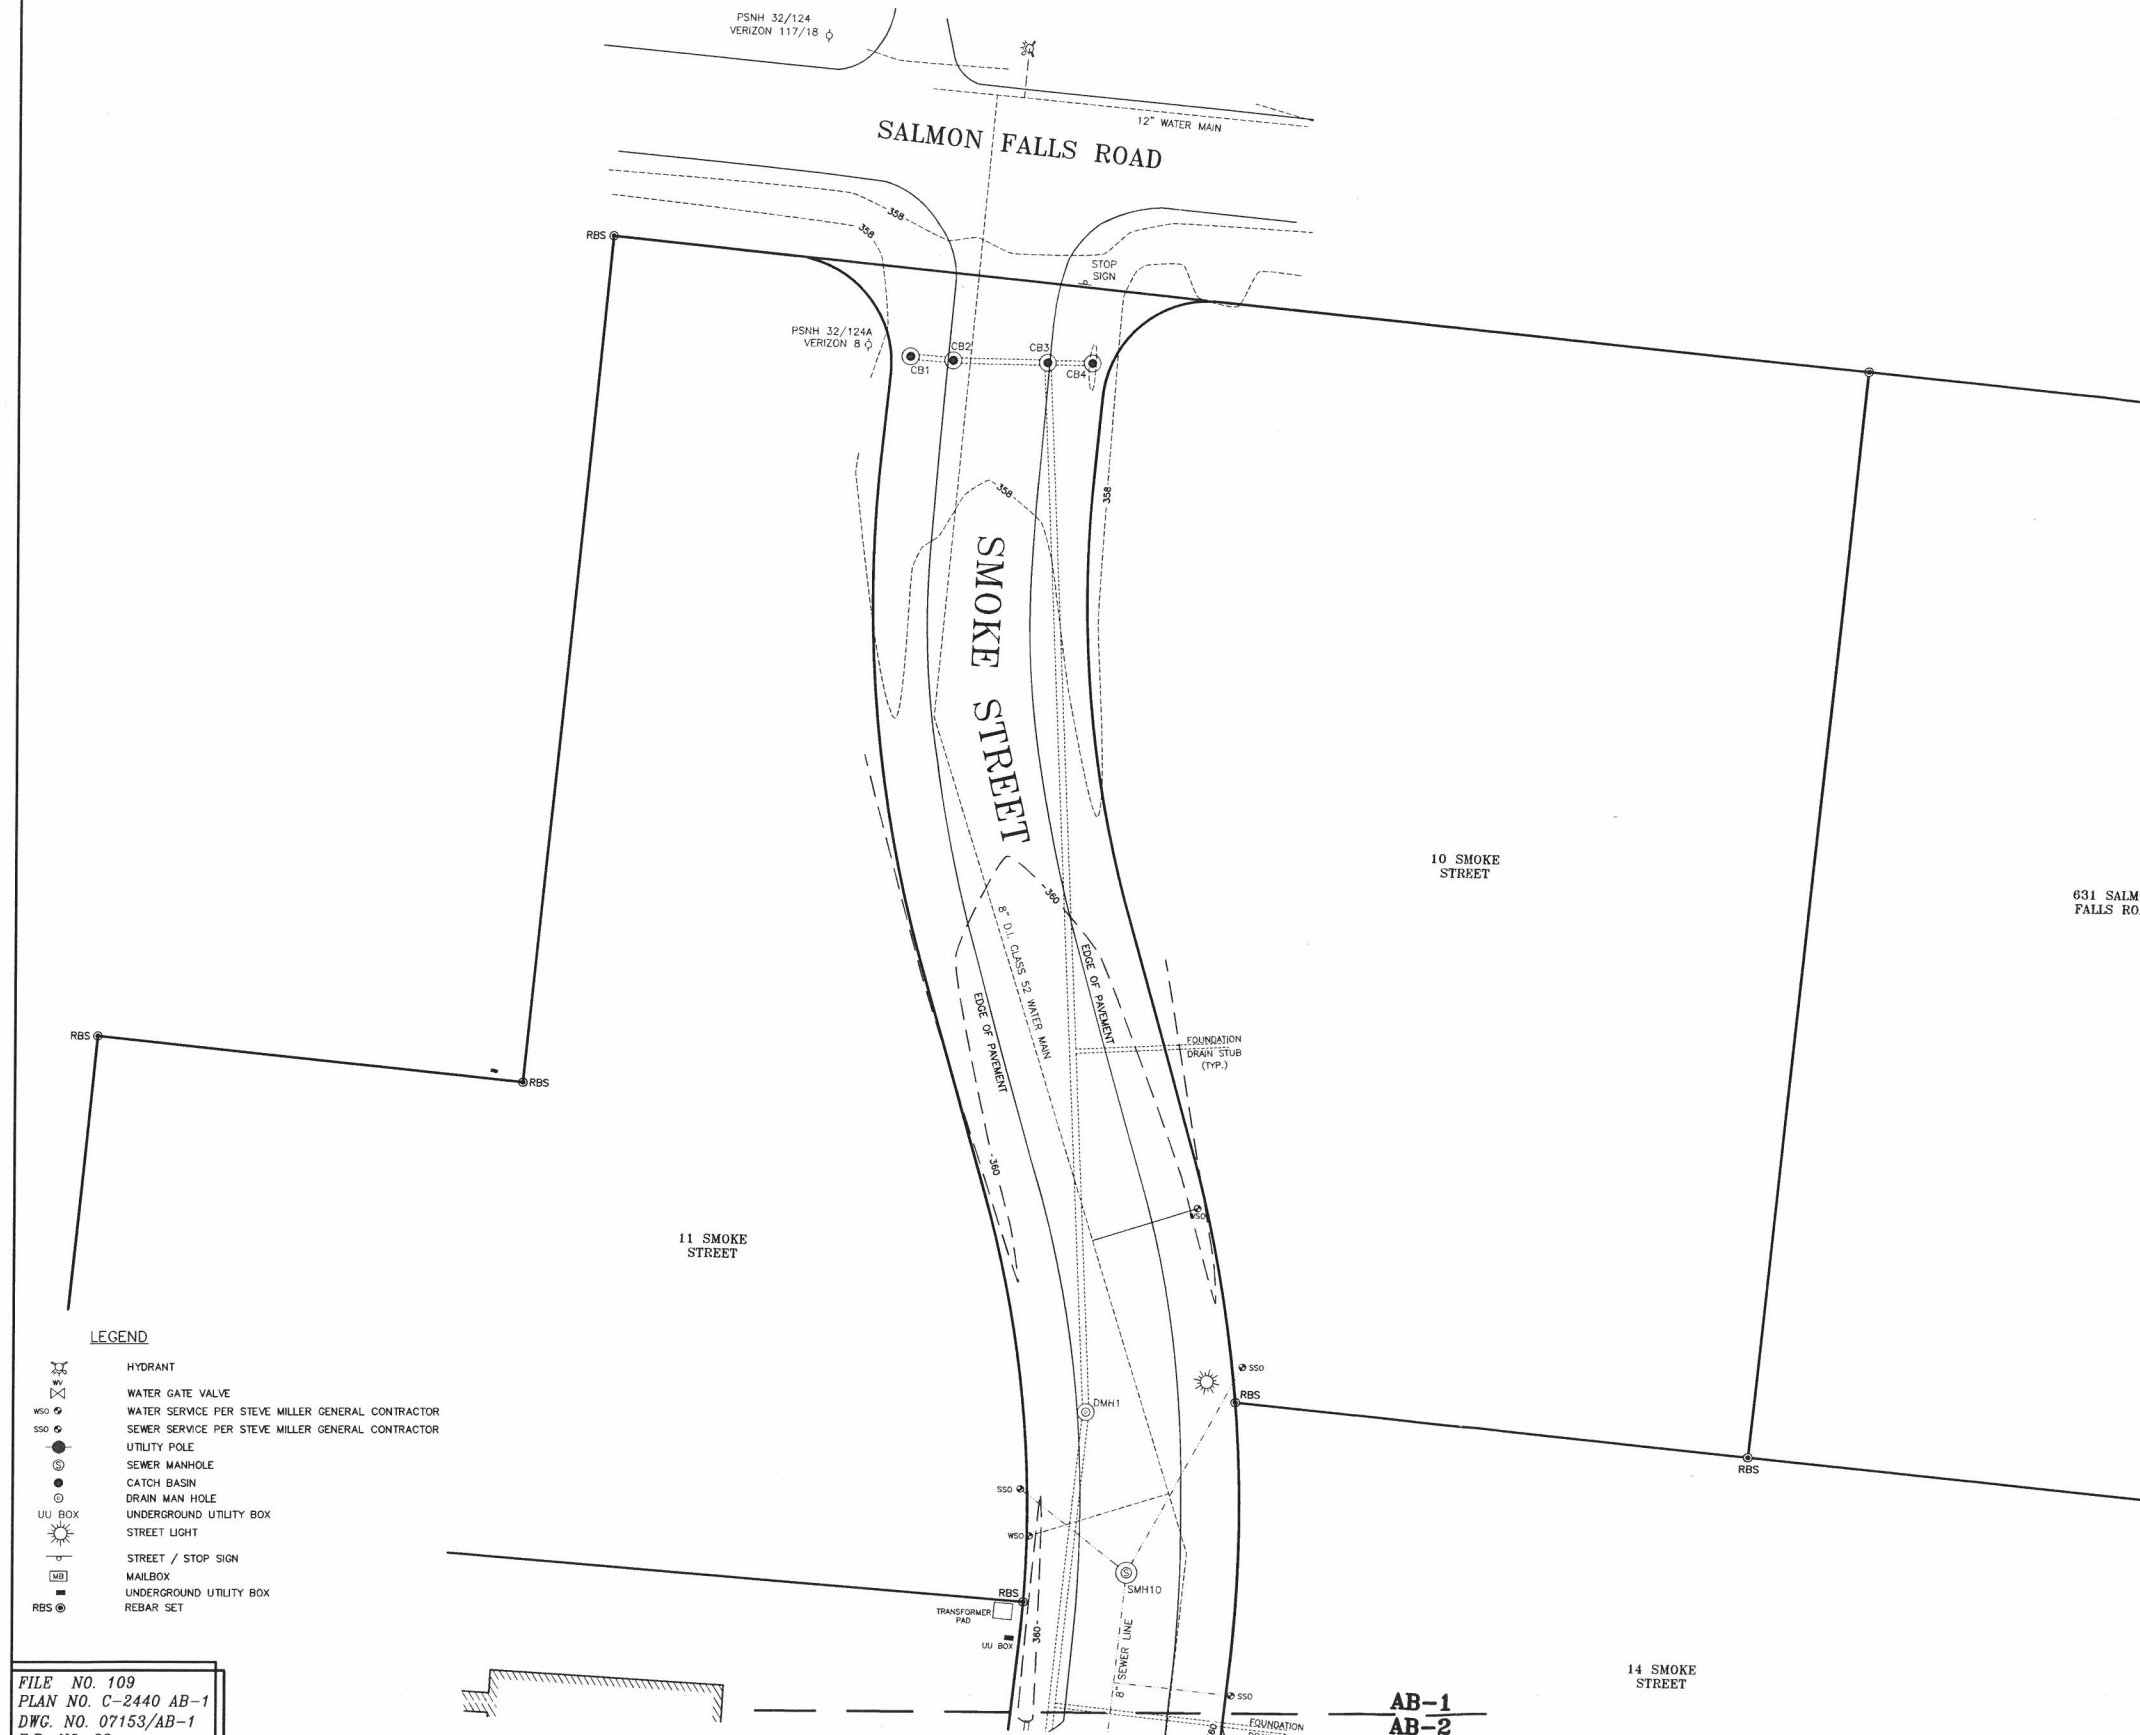


CATCH BASIN ELEVATIONS	
CB1- RIM ELEV. 355.86 INVO. 15" CPP- 352.1' SUMP- 350.3'	CB17- RIM ELEV. 348.02' INVI. 30" CPP FROM CB15- 343.0' INVI. 12"CPP FROM CB16- 344.1' INVO. 30" CPP- 342.9' SUMP- 339.9'
CB2- NOT RAISED - RIM ELEV INVI. 15" CPP- 351.8' INVO. 15" CPP 351.7' SUMP- 348.7'	CB18- RIM ELEV. 345.45 INVI. 30" CPP- 340.7' INVO. 30" CPP- 340.6 SUMP- 337.2'
CB3- RIM ELEV. 357.56' INVI. 15" CPP FROM CB2- 351.4' INVI. 12" CPP FROM CB4- 351.6' INVO. 350.9' INVO. 30" CPP- 340.1' SUMP- 348.0'	CB19- RIM ELEV. 347.42' INVI. 30" CPP- 340.3' INVO. 30" CPP- 340.1' SUMP- 337.3'
CB4- RIM ELEV. 355.78' INVI. 12" CPP- 352.0' SUMP- 348.9'	CB20- RIM ELEV. 347.22' INVI. 30" CPP- 339.9' INVO. 30" CPP- 339.8' SUMP- 336.9'
CB5- RIM ELEV. 357.42' INVO. 15" CPP- 353.3' SUMP- 350.4'	CB21- RIM ELEV. 344.81' INVI. 30" CPP- 340.0' INVO. 36" CPP- 339.0' SUMP- 336.5'
CB6- RIM ELEV. 359.04' INVI. 15" CPP FROM CB15- 352.9' INVI. 18"CPP FROM DMH1- 349.2' INVO. 18" CPP- 349.0' SUMP- 346.4'	DMH1 - RIM ELEV. 361.71' INVI. 18" CPP- 350.2' INVO. 18" CPP- 350.2' SUMP- 348.9'
CB7- RIM ELEV. 358.84' INVI. 18" CPP- 348.7' INVO. 24" CPP- 348.2' SUMP- 345.4'	DMH2- RIM ELEV. 341.50' INVI. 36" CPP- 336.65' INVO. 36" CPP- 336.6' SUMP- 336.5'
CB9- RIM ELEV. 356.96' INVI. 18" CPP- 348.7' INVO. 24" CPP- 348.2' SUMP- 345.4'	SEWER MANHOLE ELEVATIONS SMH10- RIM ELEV. 361.90' INVI. 354.0'
CB10- RIM ELEV. 355.22' INVO. 12" CPP- 352.1' SUMP- 348.7'	SMH9- RIM ELEV. 359.53' INVI. 8" PVC FROM SMH11- 351.7' INVI. 8" PVC FROM SMH10- 351.7' INVO. 8" PVC- 351.6'
CB11- RIM ELEV. 355.15' INVI. 12" CPP FROM CB10- 351.4' INVI. 24" CPP FROM CB9- 347.7' INVO. 24" CPP- 347.2' SUMP- 345.4'	SMH8- RIM ELEV. 357.59' INVI. 8" PVC- 349.4' INVO. 8" PVC- 349.3'
CB12- RIM ELEV. 352.73' INVO. 12" CPP- 349.9' SUMP- 346.9'	SMH7- RIM ELEV. 355.60' INVI. 8" PVC- 347.7' INVO. 8" PVC- 347.6'
CB13- RIM ELEV. 352.82' INVI. 12" CPP FROM CB12 349.0' INVI. 24" CPP FROM CB11 346.2' INVO. 24" CPP 346.1' SUMP- 343.3'	SMH6- RIM ELEV. 353.53' INVI. IN 8" PVC- 345.8' INVO. 8" PVC- 345.7'
CB14- RIM ELEV. 350.70' INVO. 12" CPP- 348.0' SUMP- 343.8'	SMH4- RIM ELEV. 351.54' INVI. 8" PVC FROM SMH6- 340.5' INVI. 8" PVC FROM SMH5- 340.6' INVO. 8" PVC TO SMH3- 340.5'
CB15- RIM ELEV. 350.75' INVI. 24" CPP FROM CB13- 345.2' INVI. 12" CPP FROM CB14- 346.5' INVO. 344.8'	SMH5- RIM ELEV. 349.01' INVO. 8" PVC- 341.9'
CB16- RIM ELEV. 348.03' INVO. 12" CPP- 343.7' SUMP- 341.4'	
CB17- RIM ELEV. 348.02' INVI. 30" CPP FROM CB15- 343.0' INVI. 12"CPP FROM CB16- 344.1' INVO. 30" CPP- 342.9' SUMP- 339.9'	

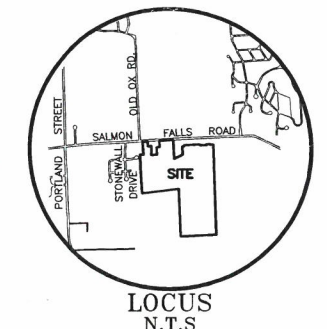

PHASE 1
AS-BUILT ROAD PLAN
 SMOKE STREET & LAREDO LANE
 ROCHESTER, N.H.
 PREPARED FOR
 GREAT WOODS DEVELOPMENT, LLC

1" = 20' SEPTEMBER 2018

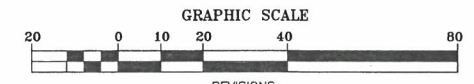

- LEGEND**
- HYDRANT
 - WATER GATE VALVE
 - WATER SERVICE PER STEVE MILLER GENERAL CONTRACTOR
 - SEWER SERVICE PER STEVE MILLER GENERAL CONTRACTOR
 - UTILITY POLE
 - SEWER MANHOLE
 - CATCH BASIN
 - DRAIN MAN HOLE
 - UNDERGROUND UTILITY BOX
 - STREET LIGHT
 - STREET / STOP SIGN
 - MAILBOX
 - UNDERGROUND UTILITY BOX
 - REBAR SET

FILE NO. 109
 PLAN NO. C-2440 AB-1
 DWG. NO. 07153/AB-1
 P.B. NO. 33



31 MOONEY STREET, ALTON, NH 603-875-3948

NORWAY PLAINS ASSOCIATES, INC.

2 CONTINENTAL BLVD., ROCHESTER, NH 603-335-3948

AB-1
 AB-2


AB-1

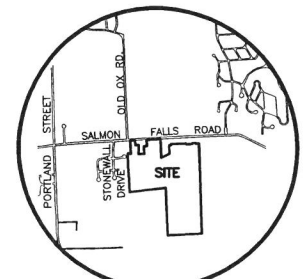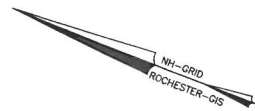

LOCUS
N.T.S

PHASE 1
AS-BUILT ROAD PLAN
SMOKE STREET & LAREDO LANE
ROCHESTER, N.H.
PREPARED FOR
GREAT WOODS DEVELOPMENT, LLC

1" = 20' SEPTEMBER 2018

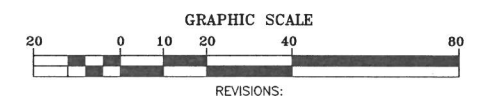

AB-2



LEGEND




- HYDRANT
- WATER GATE VALVE
- W50 WATER SERVICE PER STEVE MILLER GENERAL CONTRACTOR
- S50 SEWER SERVICE PER STEVE MILLER GENERAL CONTRACTOR
- UTILITY POLE
- SEWER MANHOLE
- CATCH BASIN
- DRAIN MAN HOLE
- UNDERGROUND UTILITY BOX
- STREET LIGHT
- STREET / STOP SIGN
- MAILBOX
- UNDERGROUND UTILITY BOX
- REBAR SET

FILE NO. 109
PLAN NO. C-2440 AB-1
DWG. NO. 07153/AB-1
F.B. NO. 33


31 MOONEY STREET, ALTON, NH 603-875-3948

NORWAY PLAINS ASSOCIATES, INC.

2 CONTINENTAL BLVD., ROCHESTER, NH 603-335-3948


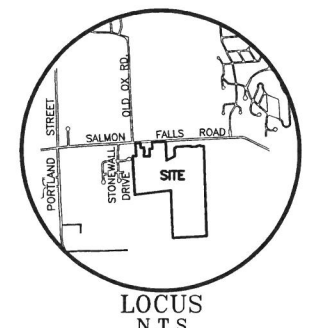
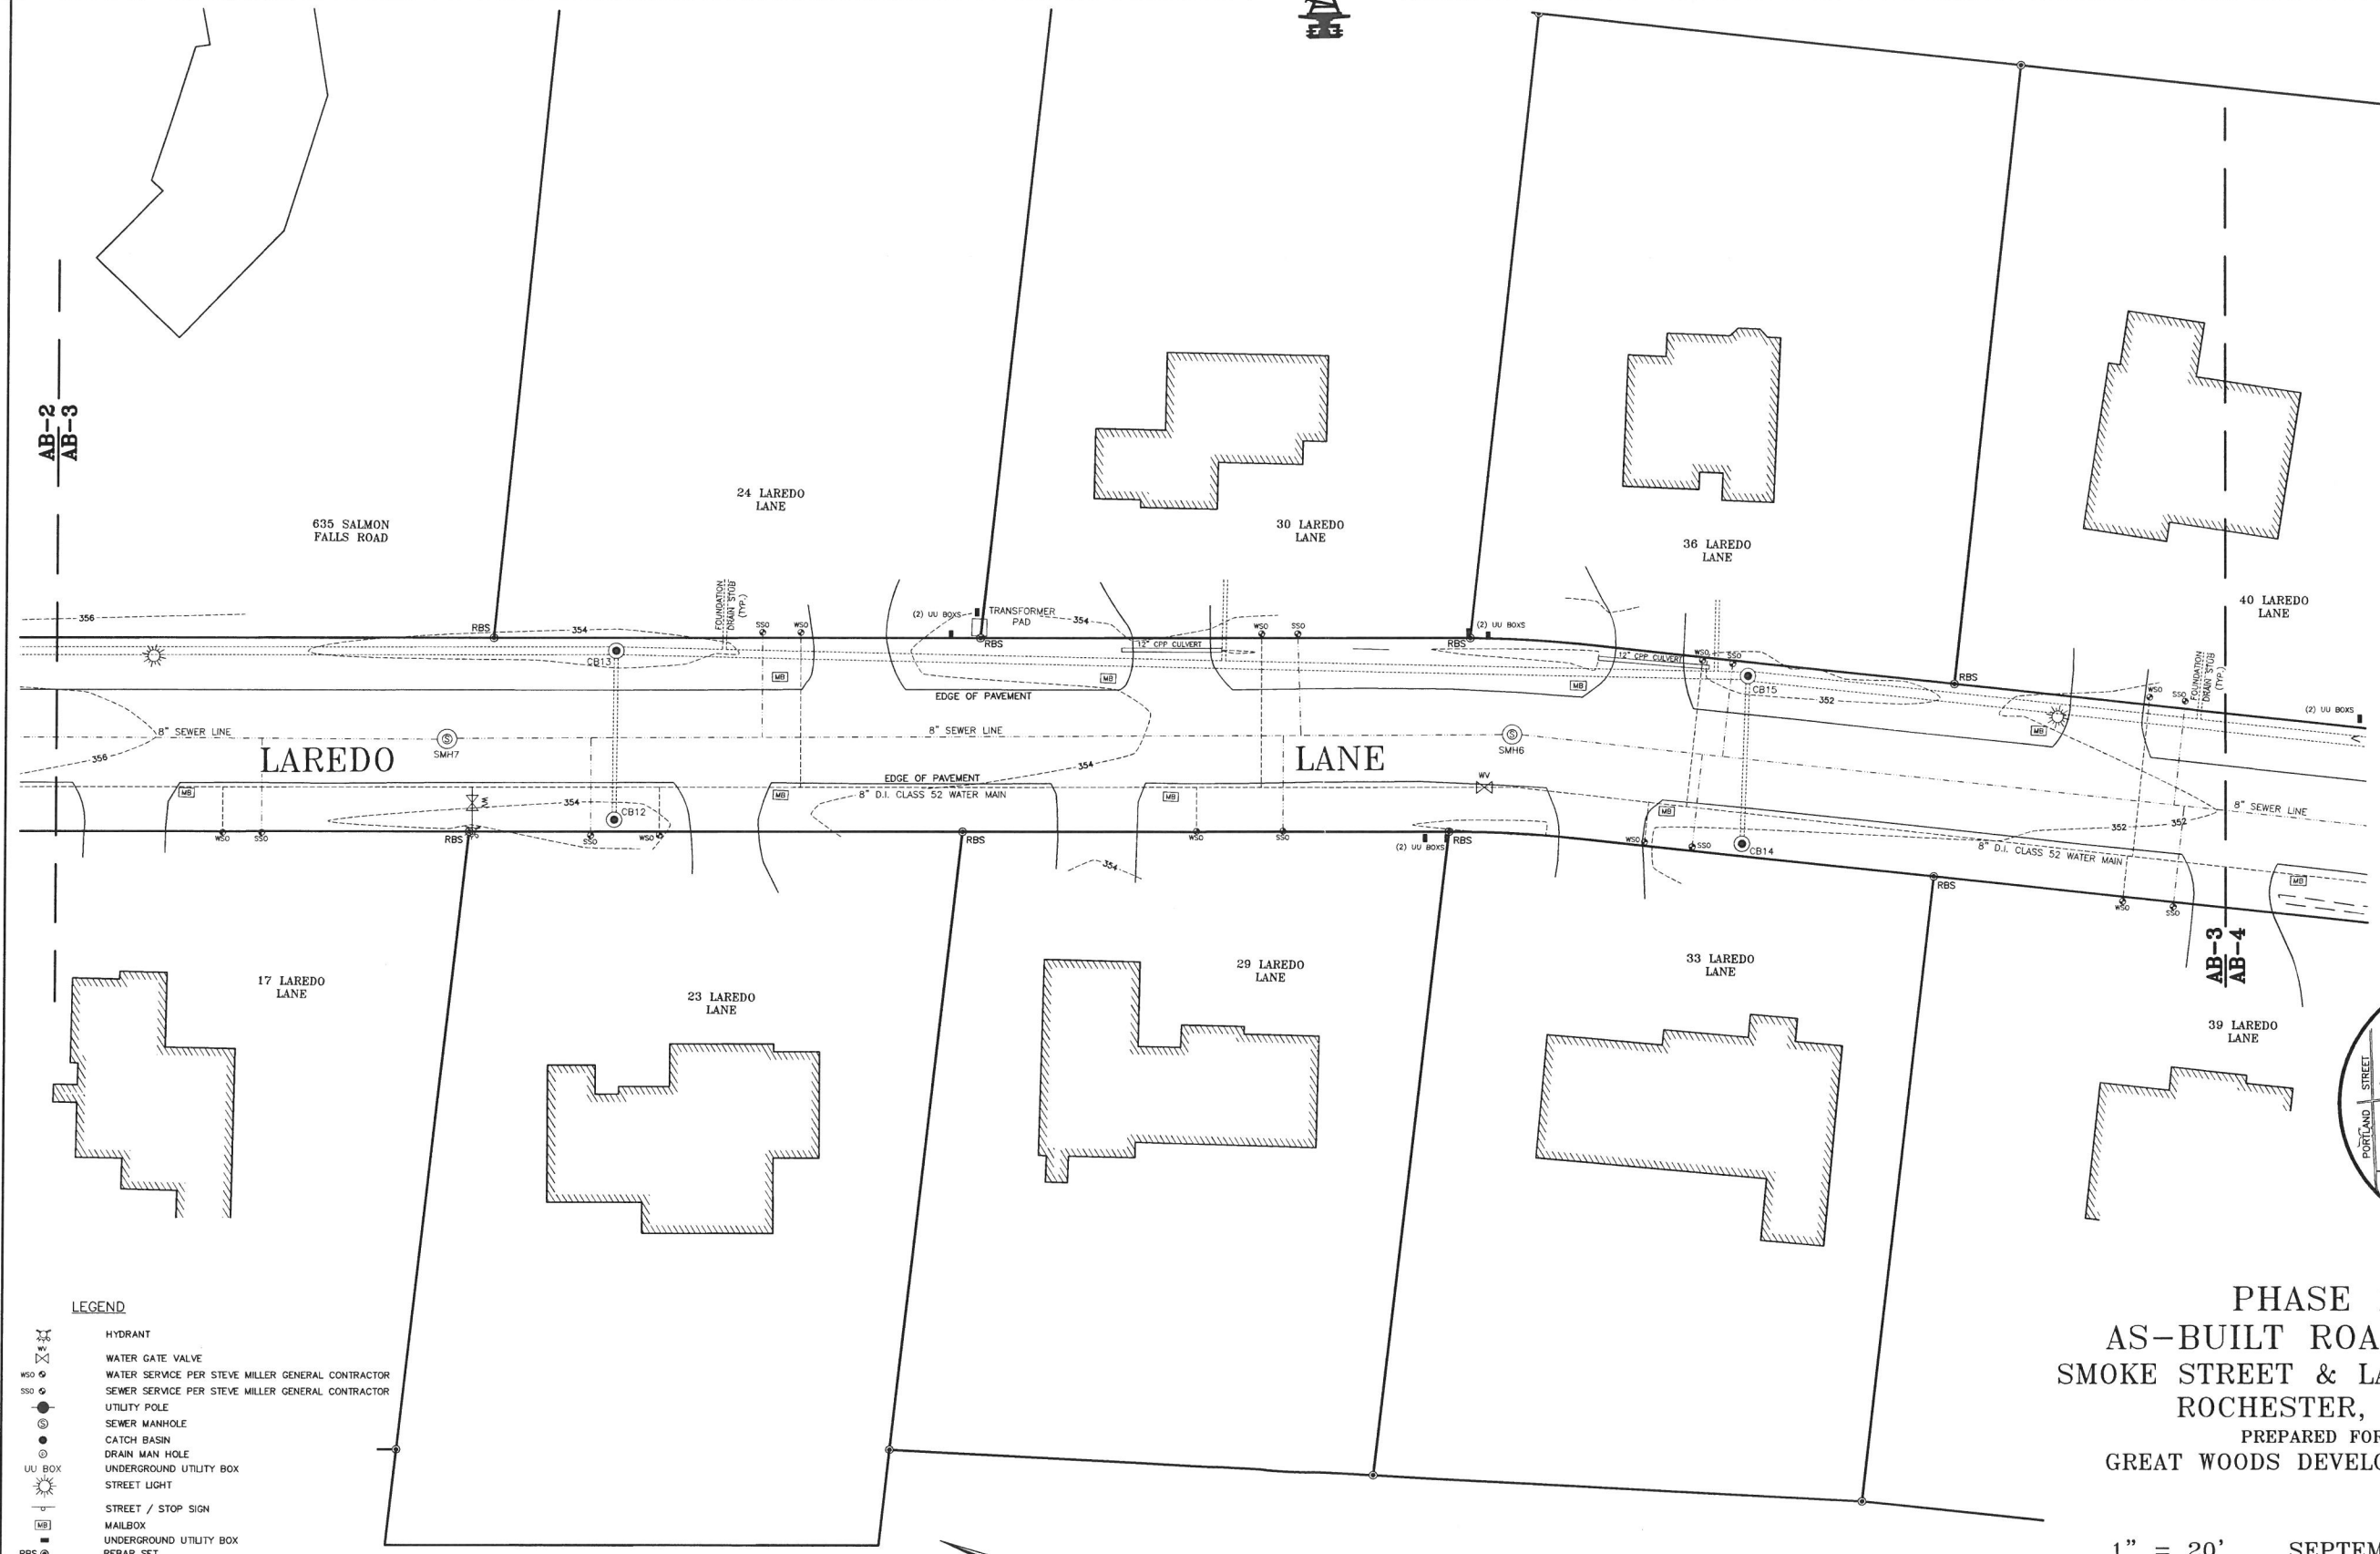
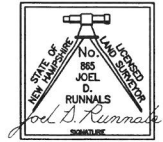


PHASE 1
AS-BUILT ROAD PLAN
SMOKE STREET & LAREDO LANE
ROCHESTER, N.H.
PREPARED FOR
GREAT WOODS DEVELOPMENT, LLC

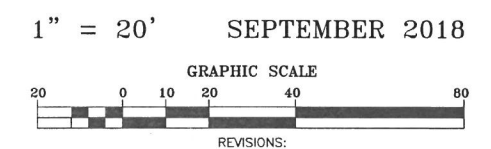


- LEGEND**
- HYDRANT
 - WATER GATE VALVE
 - WATER SERVICE PER STEVE MILLER GENERAL CONTRACTOR
 - SEWER SERVICE PER STEVE MILLER GENERAL CONTRACTOR
 - UTILITY POLE
 - SEWER MANHOLE
 - CATCH BASIN
 - DRAIN MAN HOLE
 - UNDERGROUND UTILITY BOX
 - STREET LIGHT
 - STREET / STOP SIGN
 - MAILBOX
 - UNDERGROUND UTILITY BOX
 - REBAR SET

FILE NO. 109
PLAN NO. C-2440 AB-1
DWG. NO. 07153/AB-1
F.B. NO. 33

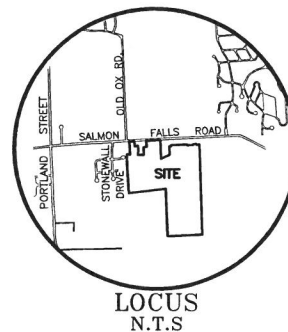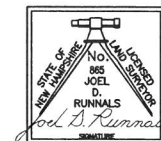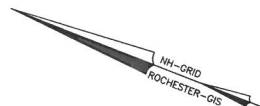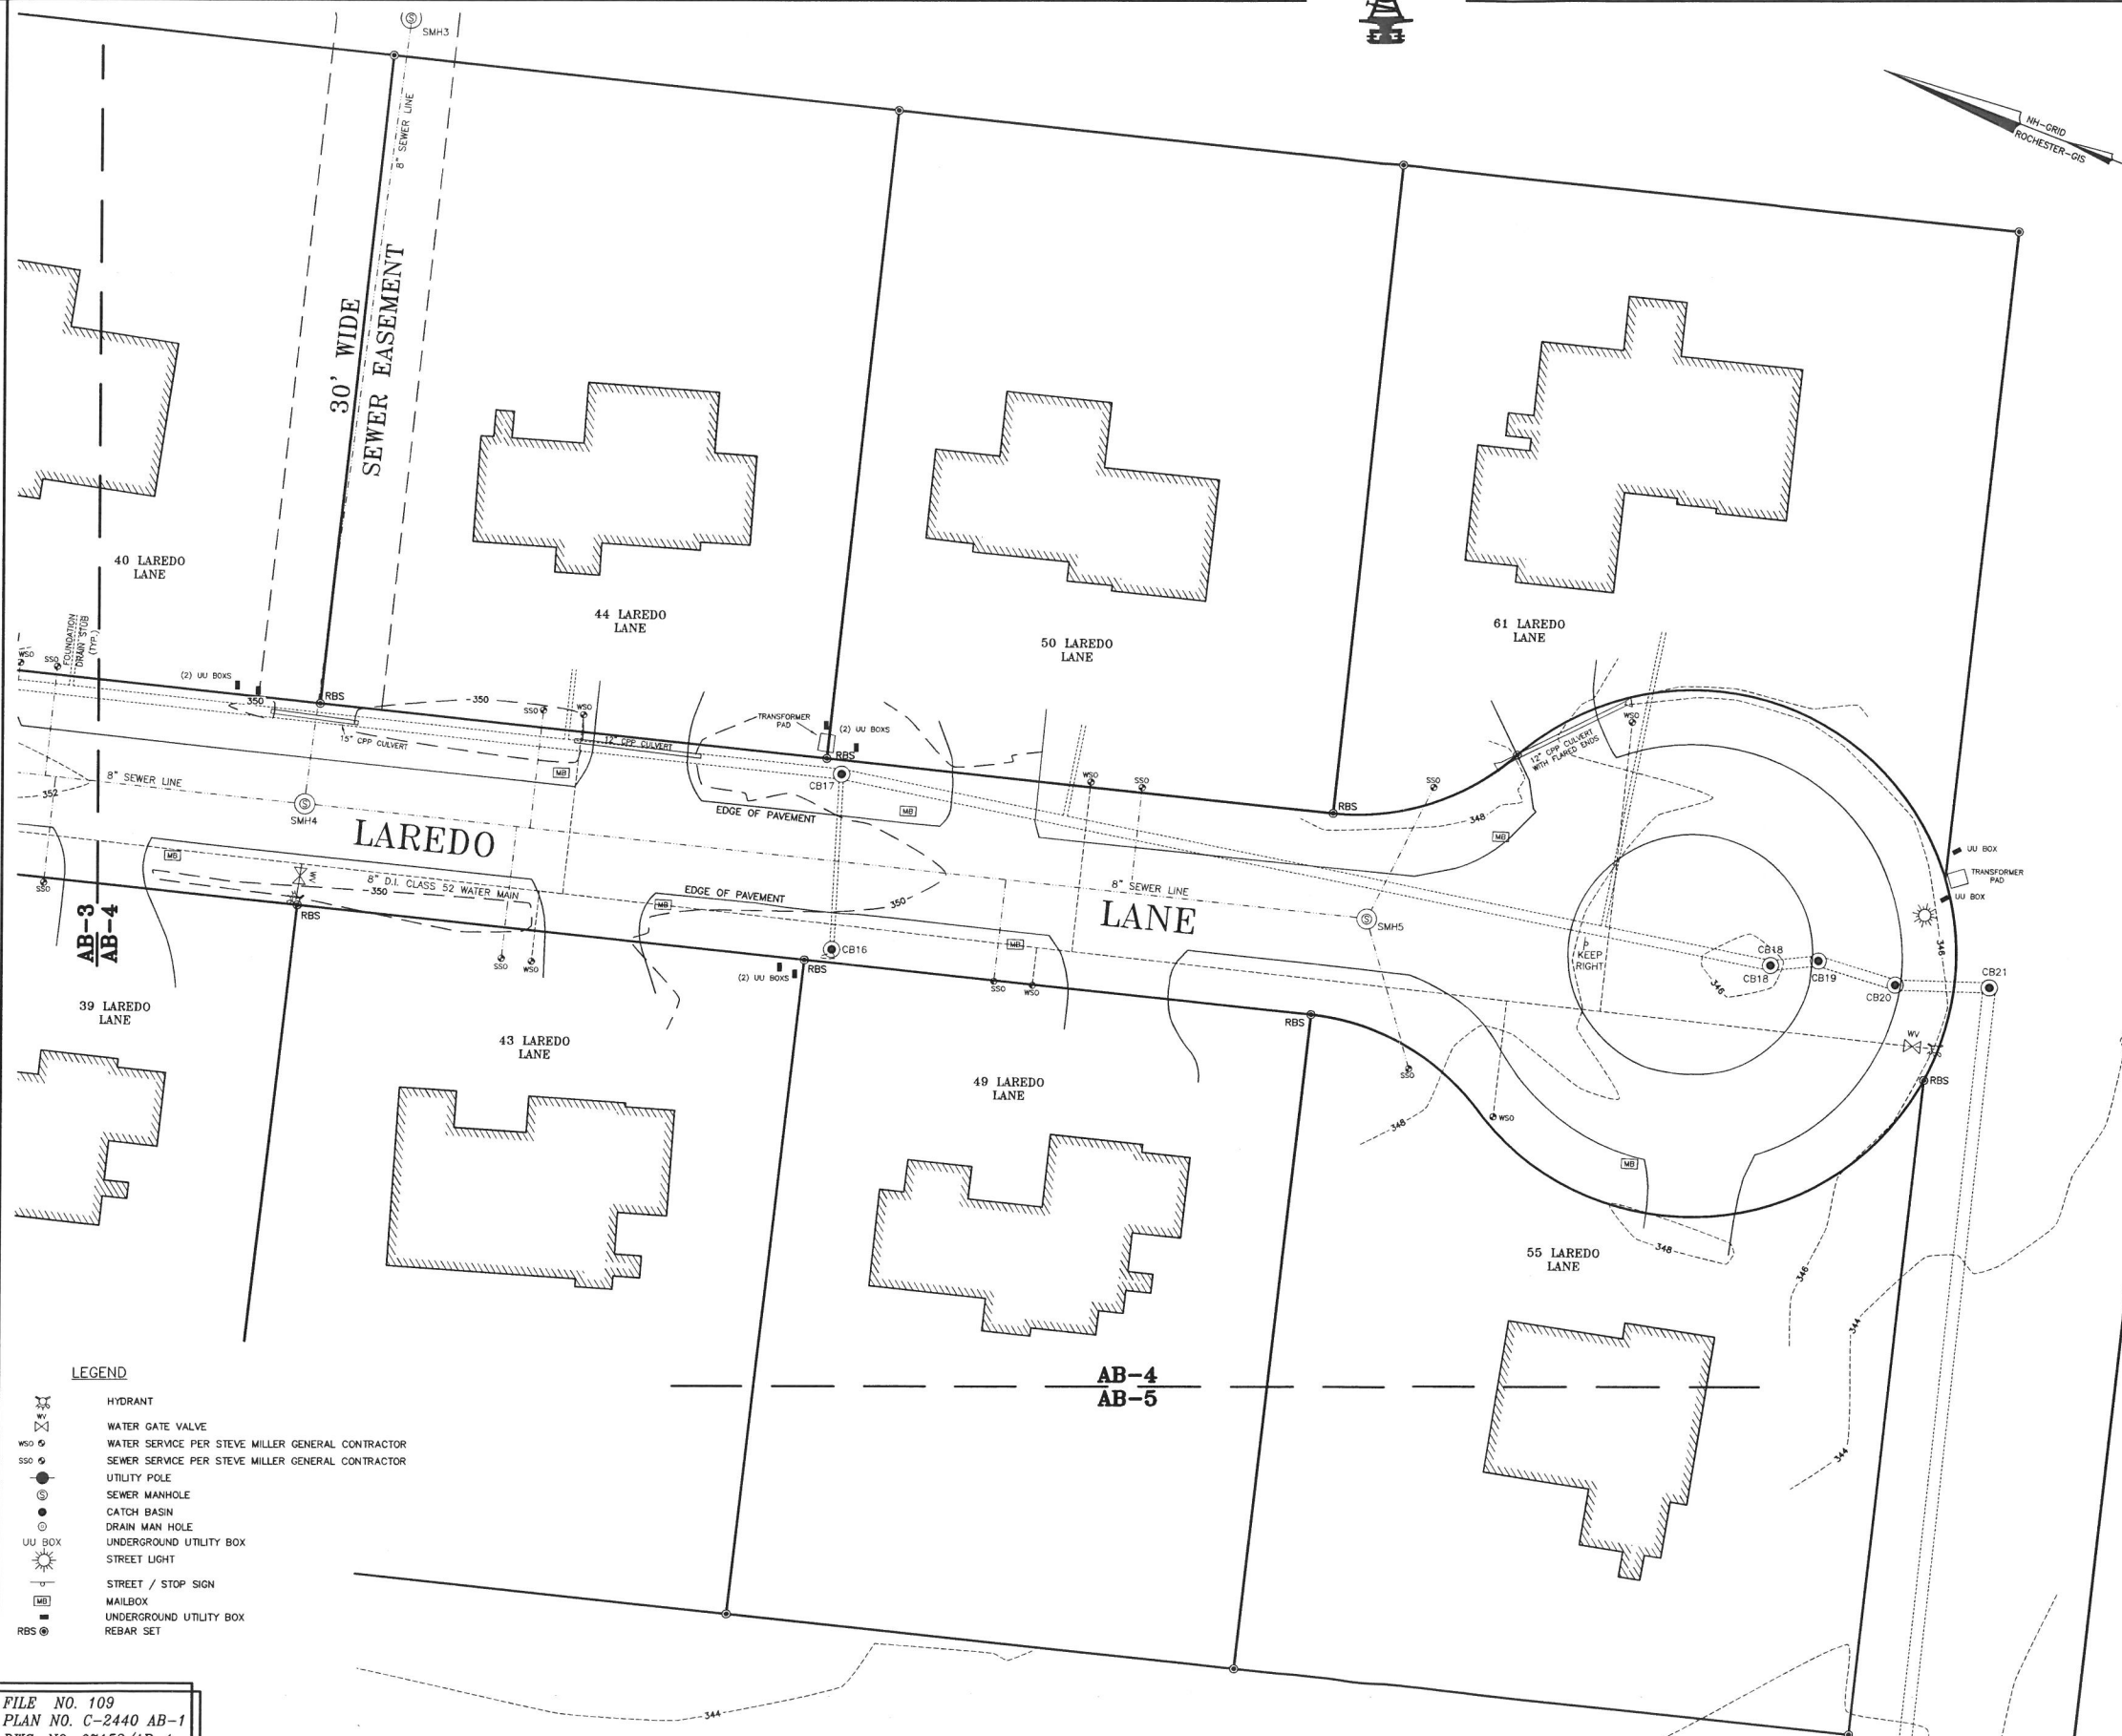




PHASE 1
AS-BUILT ROAD PLAN
SMOKE STREET & LAREDO LANE
ROCHESTER, N.H.
PREPARED FOR
GREAT WOODS DEVELOPMENT, LLC

1" = 20' SEPTEMBER 2018

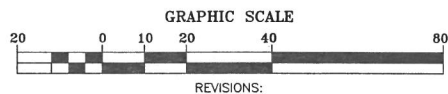

FILE NO. 109
PLAN NO. C-2440 AB-1
DWG. NO. 07153/AB-1
F.B. NO. 33


AB-4
AB-5

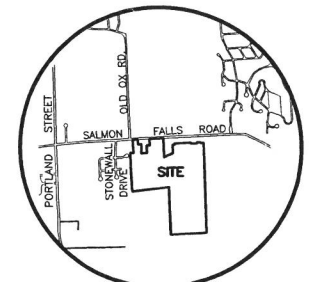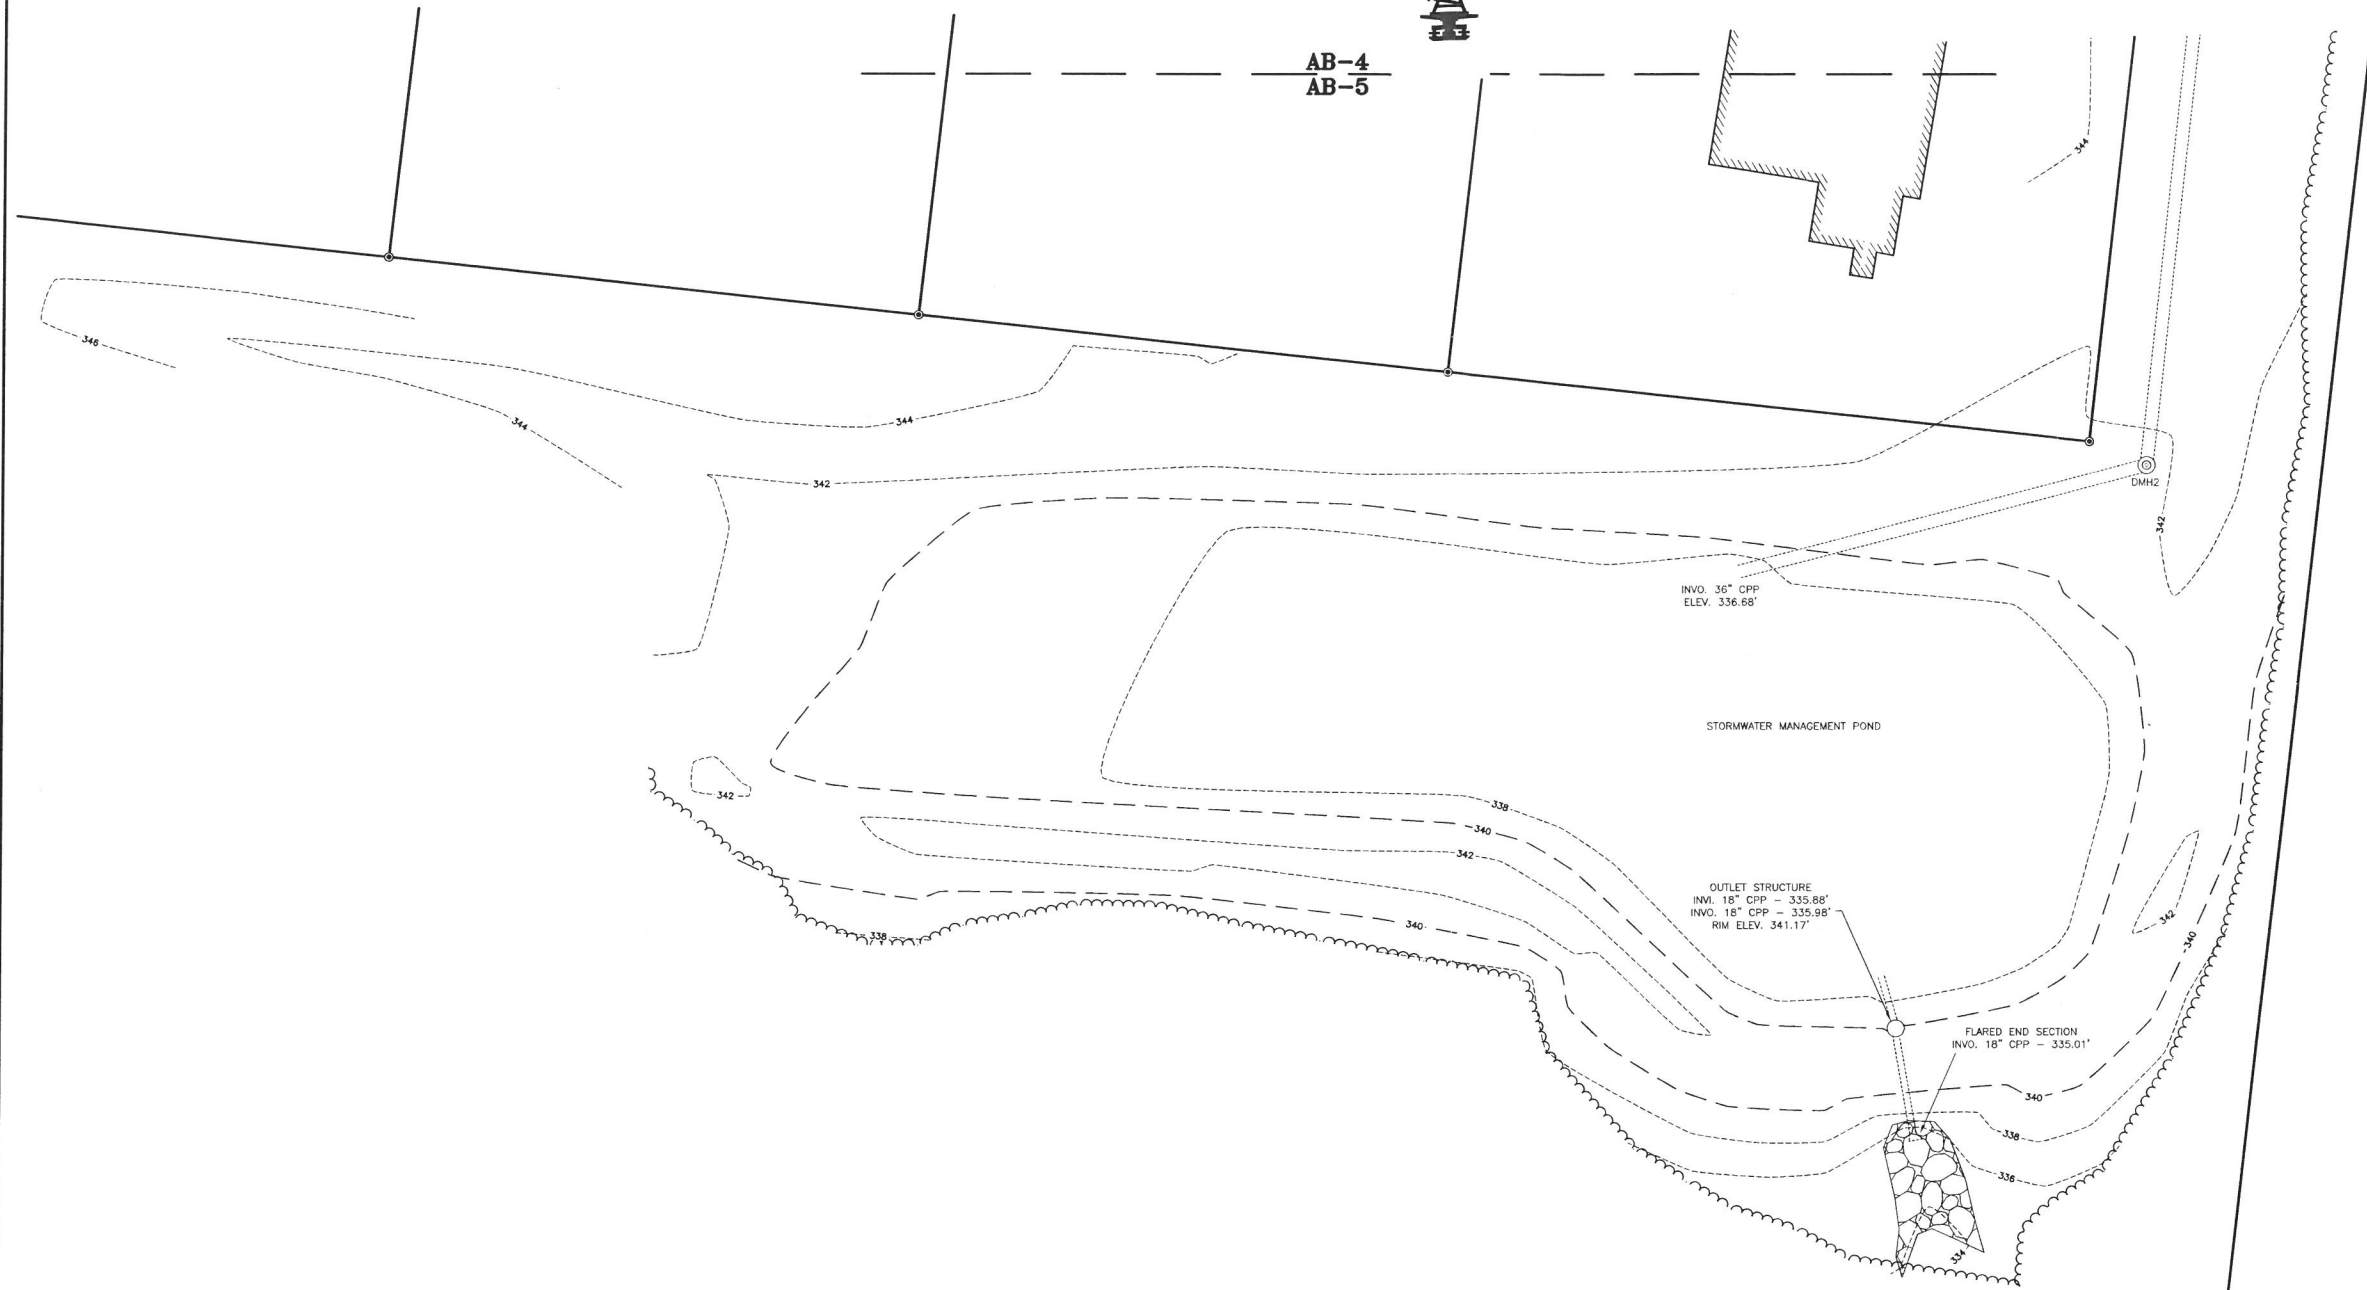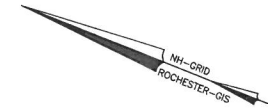

LOCUS
N.T.S

PHASE 1
AS-BUILT ROAD PLAN
SMOKE STREET & LAREDO LANE
ROCHESTER, N.H.
PREPARED FOR
GREAT WOODS DEVELOPMENT, LLC

1" = 20' SEPTEMBER 2018

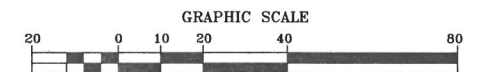

REVISIONS:

LEGEND

- HYDRANT
- WATER GATE VALVE
- WATER SERVICE PER STEVE MILLER GENERAL CONTRACTOR
- SEWER SERVICE PER STEVE MILLER GENERAL CONTRACTOR
- UTILITY POLE
- SEWER MANHOLE
- CATCH BASIN
- DRAIN MAN HOLE
- UNDERGROUND UTILITY BOX
- STREET LIGHT
- STREET / STOP SIGN
- MAILBOX
- UNDERGROUND UTILITY BOX
- REBAR SET

FILE NO. 109
PLAN NO. C-2440 AB-1
DWG. NO. 07153/AB-1
F.B. NO. 33

31 MOONEY STREET, ALTON, NH 603-875-3948

NORWAY PLAINS ASSOCIATES, INC.

2 CONTINENTAL BLVD., ROCHESTER, NH 603-335-3948

AB-5